FLOOR 24


VIEW OF CENTRAL PARK / UPPER EAST SIDE

E. 61ST STREET



24TH FLOOR 3,250 RSF

AS-BUILT PLAN — PRE-BUILT INSTALLATION

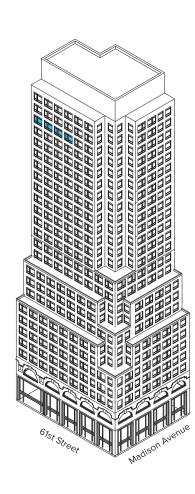



MADISON AVENUE