

667 MADISON AVENUE



24TH FLOOR (PARTIAL)

3,250 RSF

AS-BUILT PLAN — PRE-BUILT INSTALLTION

Howard Hersch
Vice Chairman
212.812.6020
howard.hersch@am.jll.com

Jonathan Fanuzzi
Executive Vice President
212.812.6044
jonathan.fanuzzi@am.jll.com

Brett Harvey
Senior Vice President
212.271.6400
brett.harvey@am.jll.com


Mort Schrader
Managing Director
212.812.6426
mort.schrader@am.jll.com

VIEW OF CENTRAL PARK / UPPER EAST SIDE

E. 61ST STREET

VIEW OF CENTRAL PARK / MIDTOWN

MADISON AVENUE

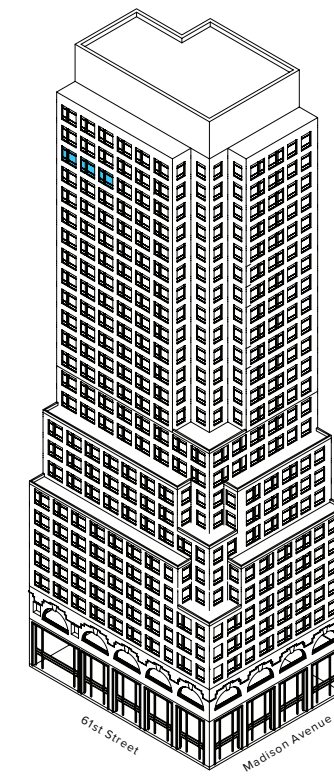

HARTZ

667 Madison Avenue
New York, NY 10065
667madison.com